




Exhibit B - Annex A & B
Annex A: Transformer Specifications & Pictures

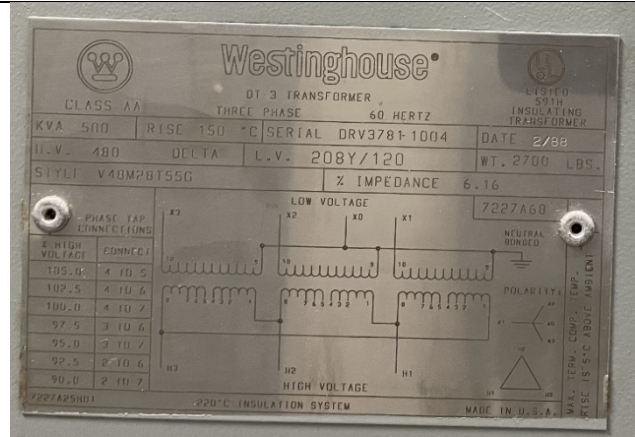

T-16

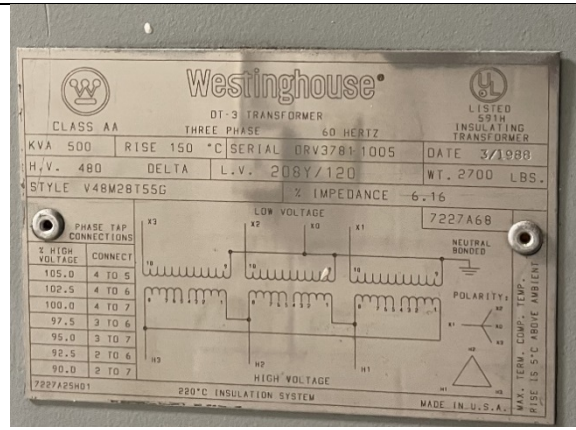


T-45

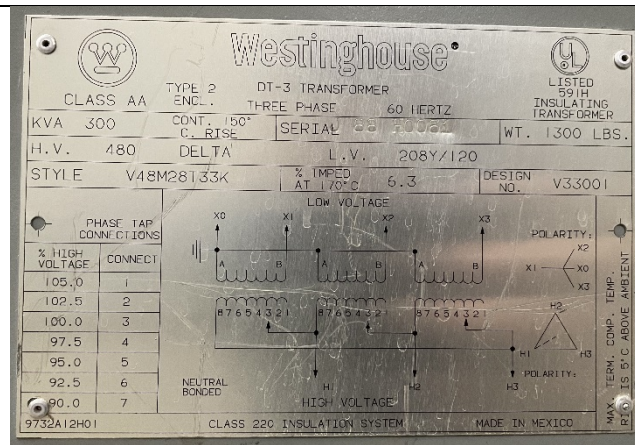

T-47

Annex B: Single Line Diagrams

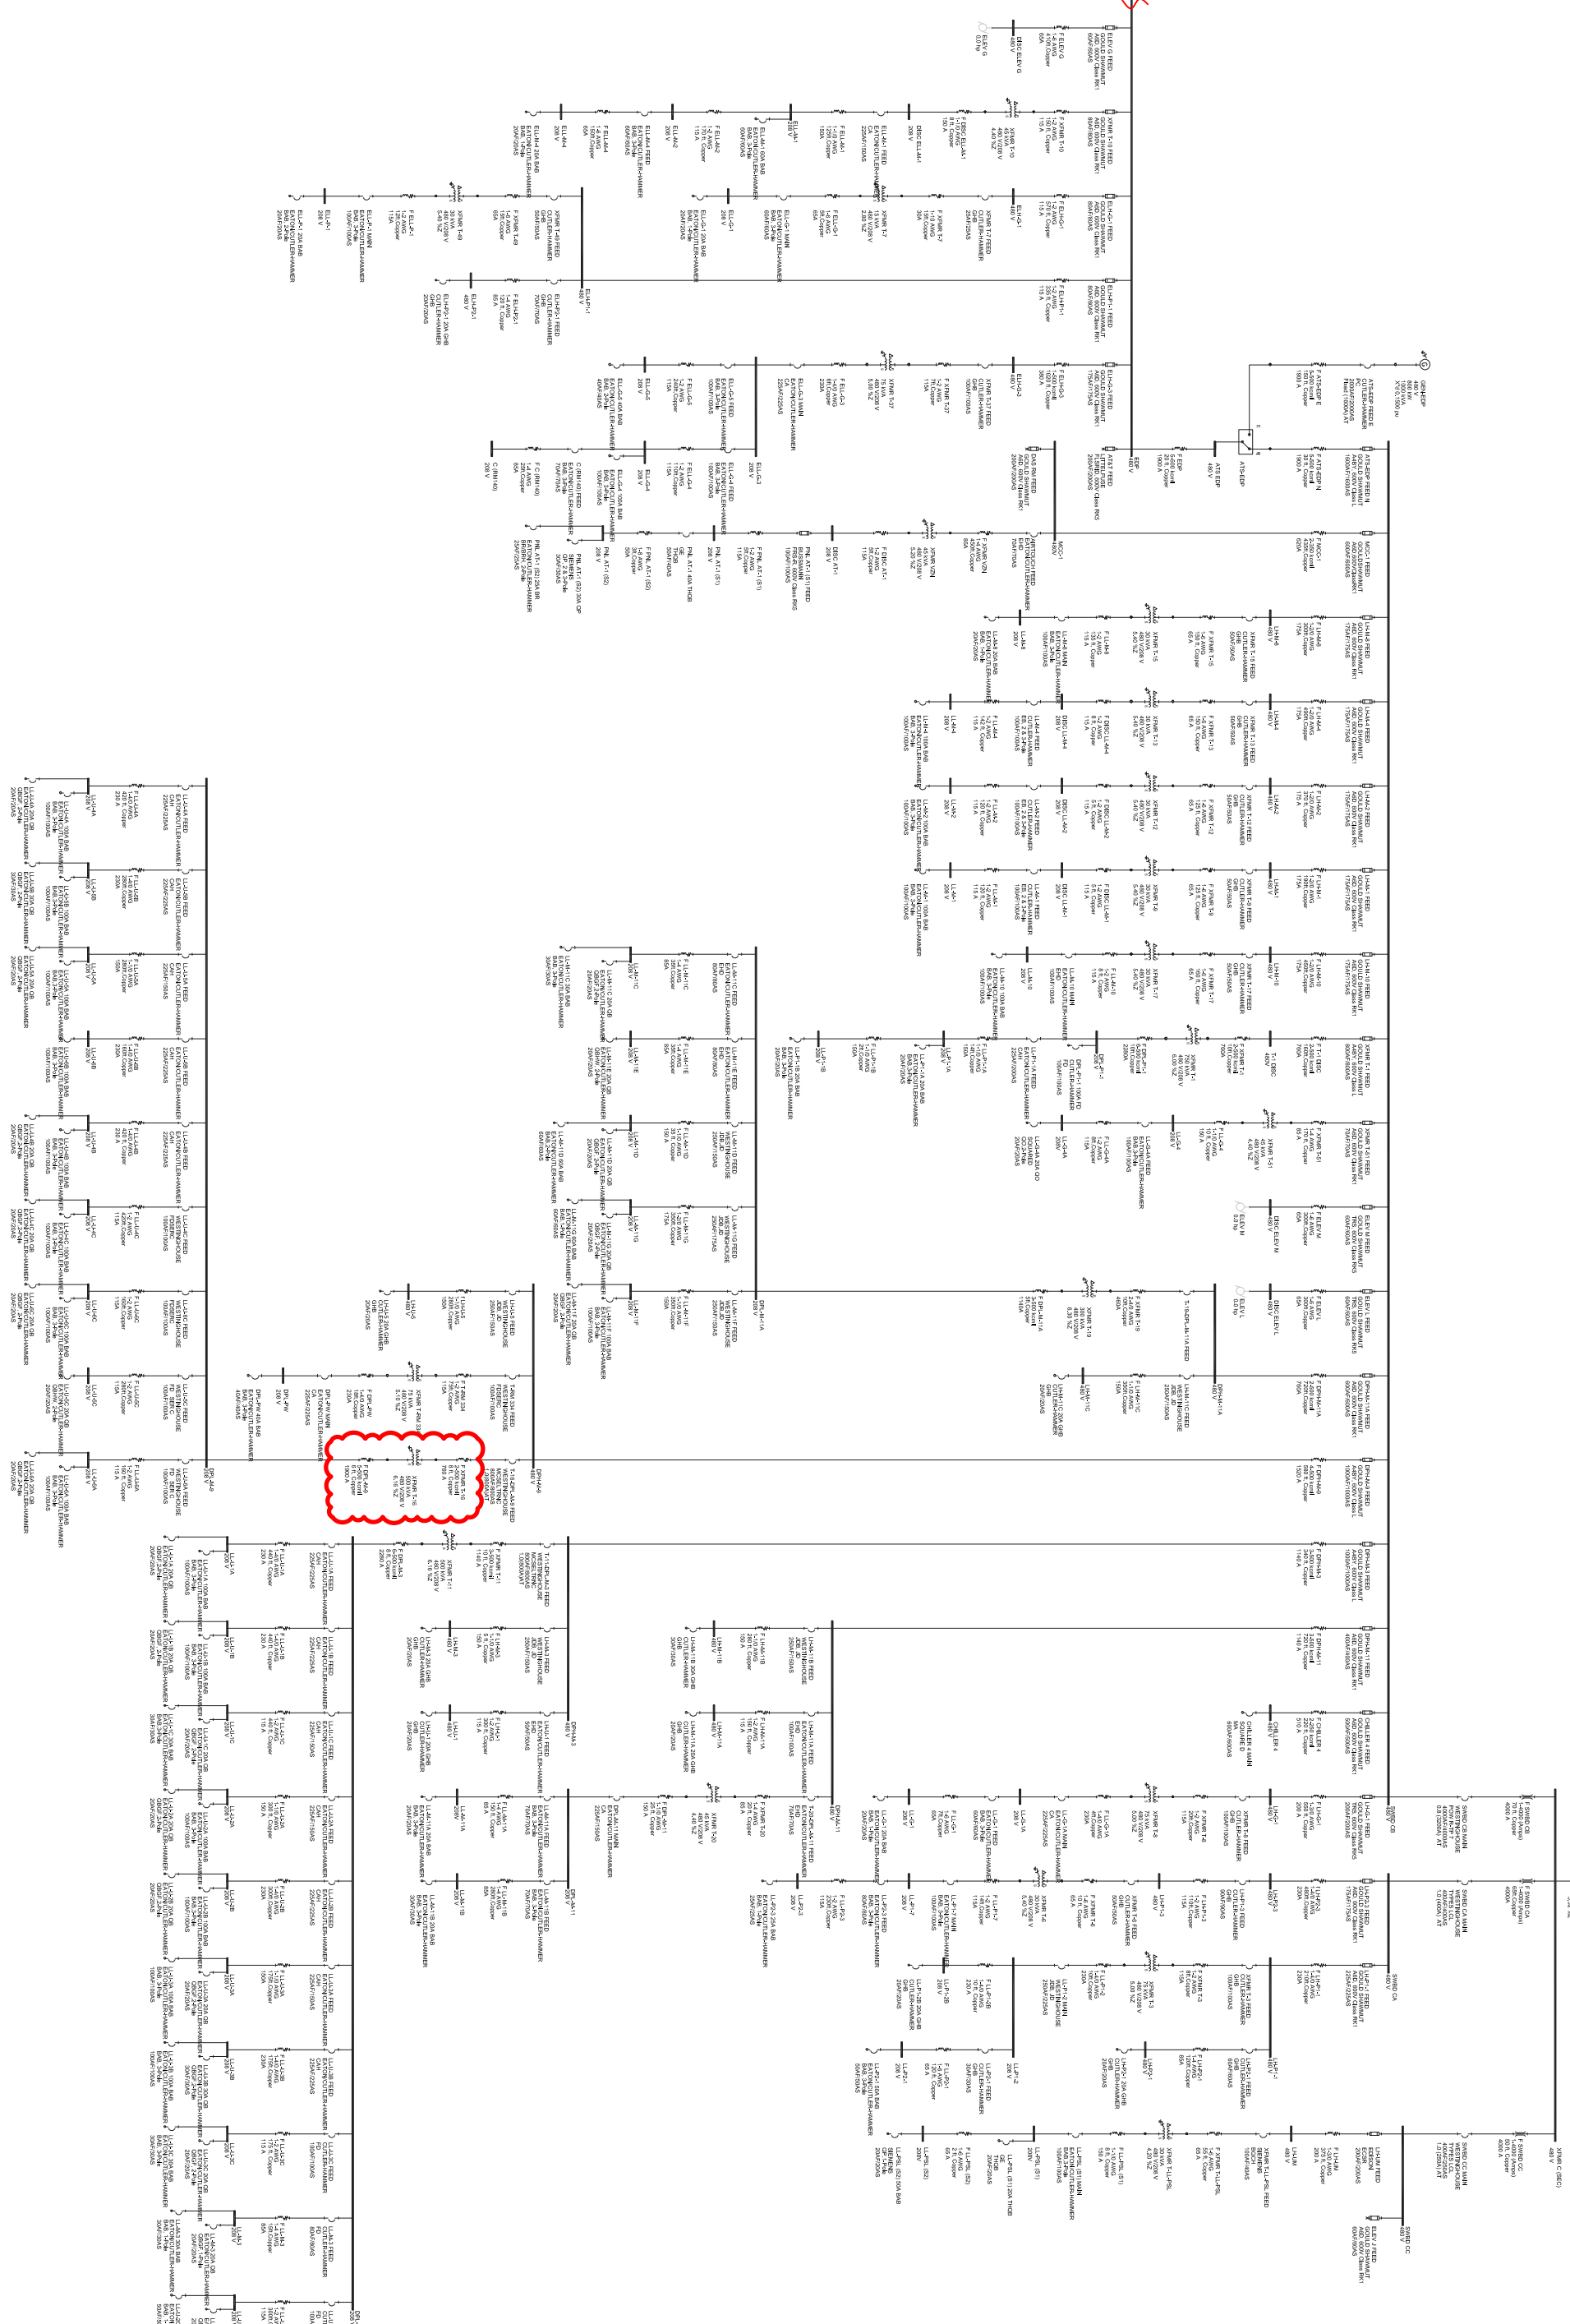

SHEET REFERENCE NUMBER
E - 2

PROJECT:
SAN DIEGO CONVENTION CENTER

PROJECT:
SAN DIEGO CONVENTION CENTER

DRAFTED BY: Omar Pagan
DATE: 03.June.2024

Rev.No	Description	Date	APR
1	AS BUILT 1	06/03/2024	
2			
3			
4			



AS BUILT 1

DRAWING BY:	Omar Pagan
CHECKED BY:	
DRAFTED BY:	Omar Pagan
DATE:	03.June.2024
SUBMITTED BY:	
CUSTOMER:	

Rev.No	Description	Date	APR
1	AS BUILT 1	06/03/2024	
2			
3			
4			

